




NORTH ELEVATION AS BUILT

REAR ELEVATION AS BUILT

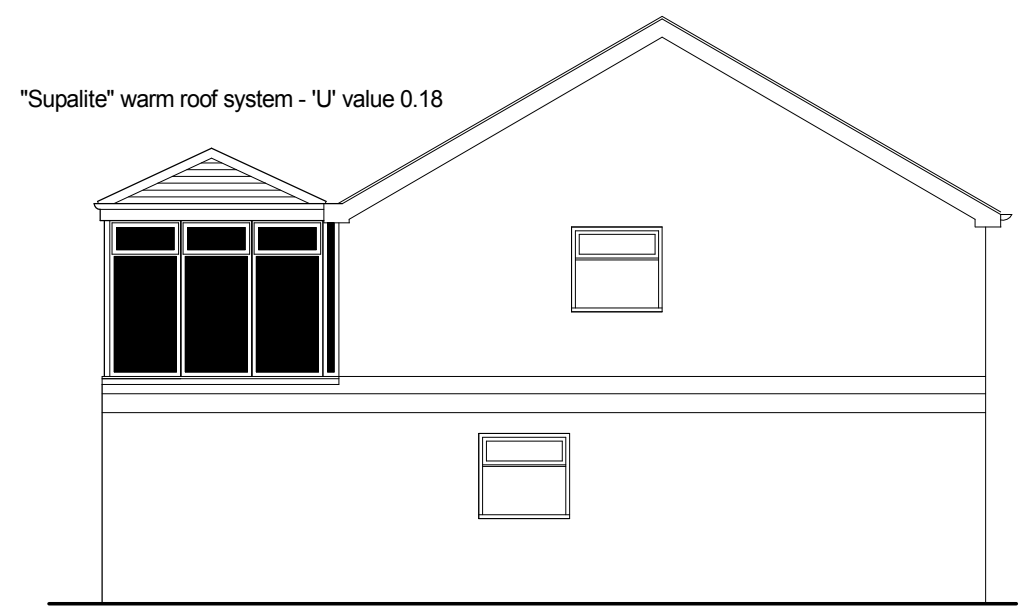

SOUTH ELEVATION AS BUILT



ORIGINAL NORTH ELEVATION

ORIGINAL REAR ELEVATION



ORIGINAL SOUTH ELEVATION

PLANNING APPLICATION DRAWING

All dimensions to be checked on site

Proposed Solid Roof to Existing Conservatory at:
"Copsewood" Boggy Lane Church Broughton Derby DE65 5AR
for Mr A Watson



SCALE 1:100@A3 DATE Sept 2019 REF. 160919/3

	design connexions	Architectural Services
	25 Linsdale Gardens Gedling Nottingham NG4 4GY e-mail: designconnexions@gmail.com	Tel. 0115 987 7185 www.designconnexions.co.uk