





FRONT ELEVATION 1

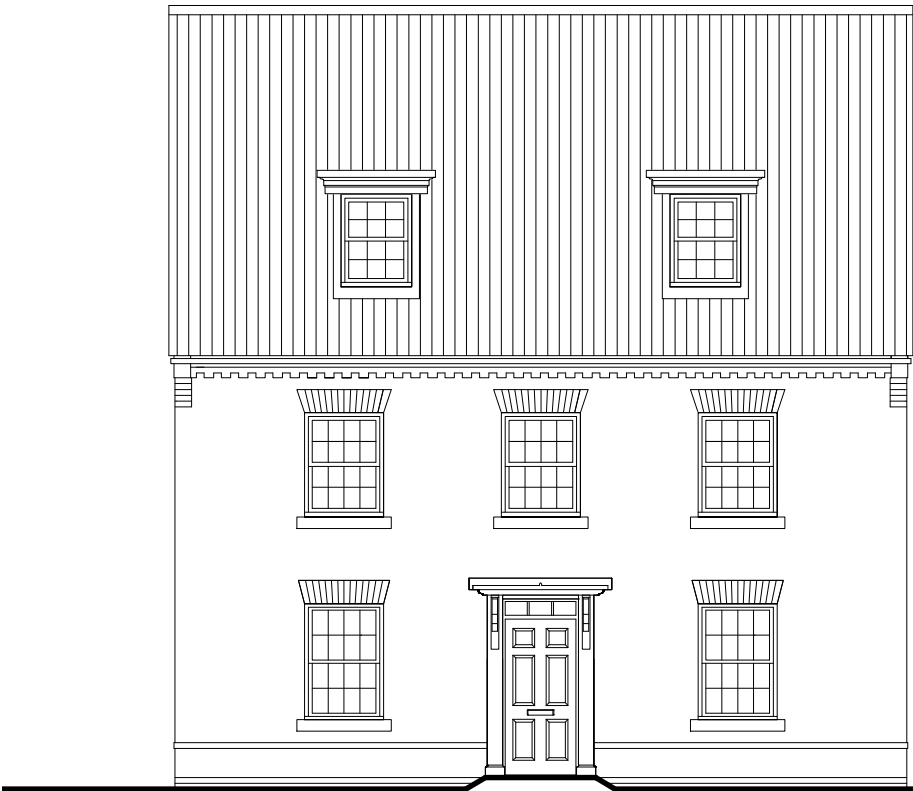

FRONT ELEVATION 2

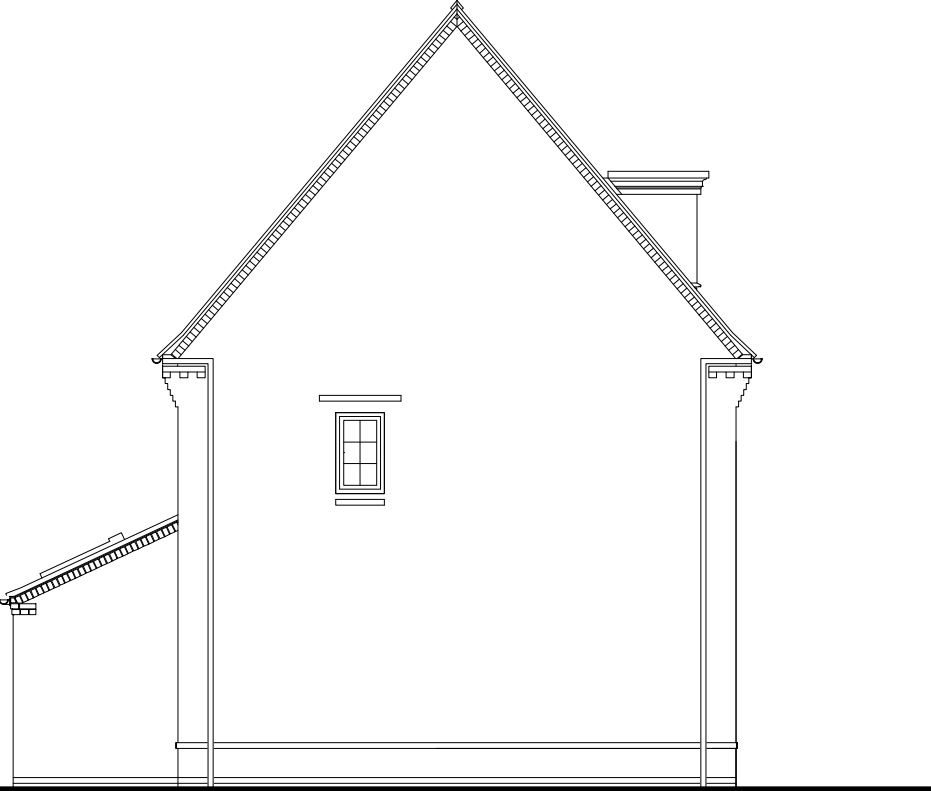

REAR ELEVATION



SIDE ELEVATION

C:\ad\dwg\house\dwg\2024\20240720\p001.dwg, 2024


TOTAL FLOOR AREA : 1830 Sqft

Sales Name: EMERSON
House Type Code: H500---X7 As Built
Spec: A1 Drawing No: 15 Date: 30.08.16
Drawn: GDT Checked: GDT Scale: 1:100

WARNING TO HOUSE PURCHASERS:
Buyers are warned that this is a working drawing and the contents of this drawing may be subject to change during the progress of the build process. The layout, form, content and dimensions specified are included for general guidance only. The finishes or features shown may alter in respect of individual properties. Whilst we make every effort to ensure our drawings are up to date there may from time to time be an unavoidable delay in updating these due to changes in regulations and/or re-planning. Purchasers are advised to check with the Sales Adviser whether any alterations have been made to this drawing. The contents of this drawing do not constitute a contract, part of any contract or warranty unless specifically incorporated into the contract. They should not be relied upon for the purposes of entering into a contract to purchase any property.

PLANNING 1 OF 2
B Refer to Data Sheet.

July 20

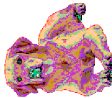

DAVID WILSON HOMES
WHERE QUALITY LIVES