






STONE PORCH - AS CONSTRUCTED

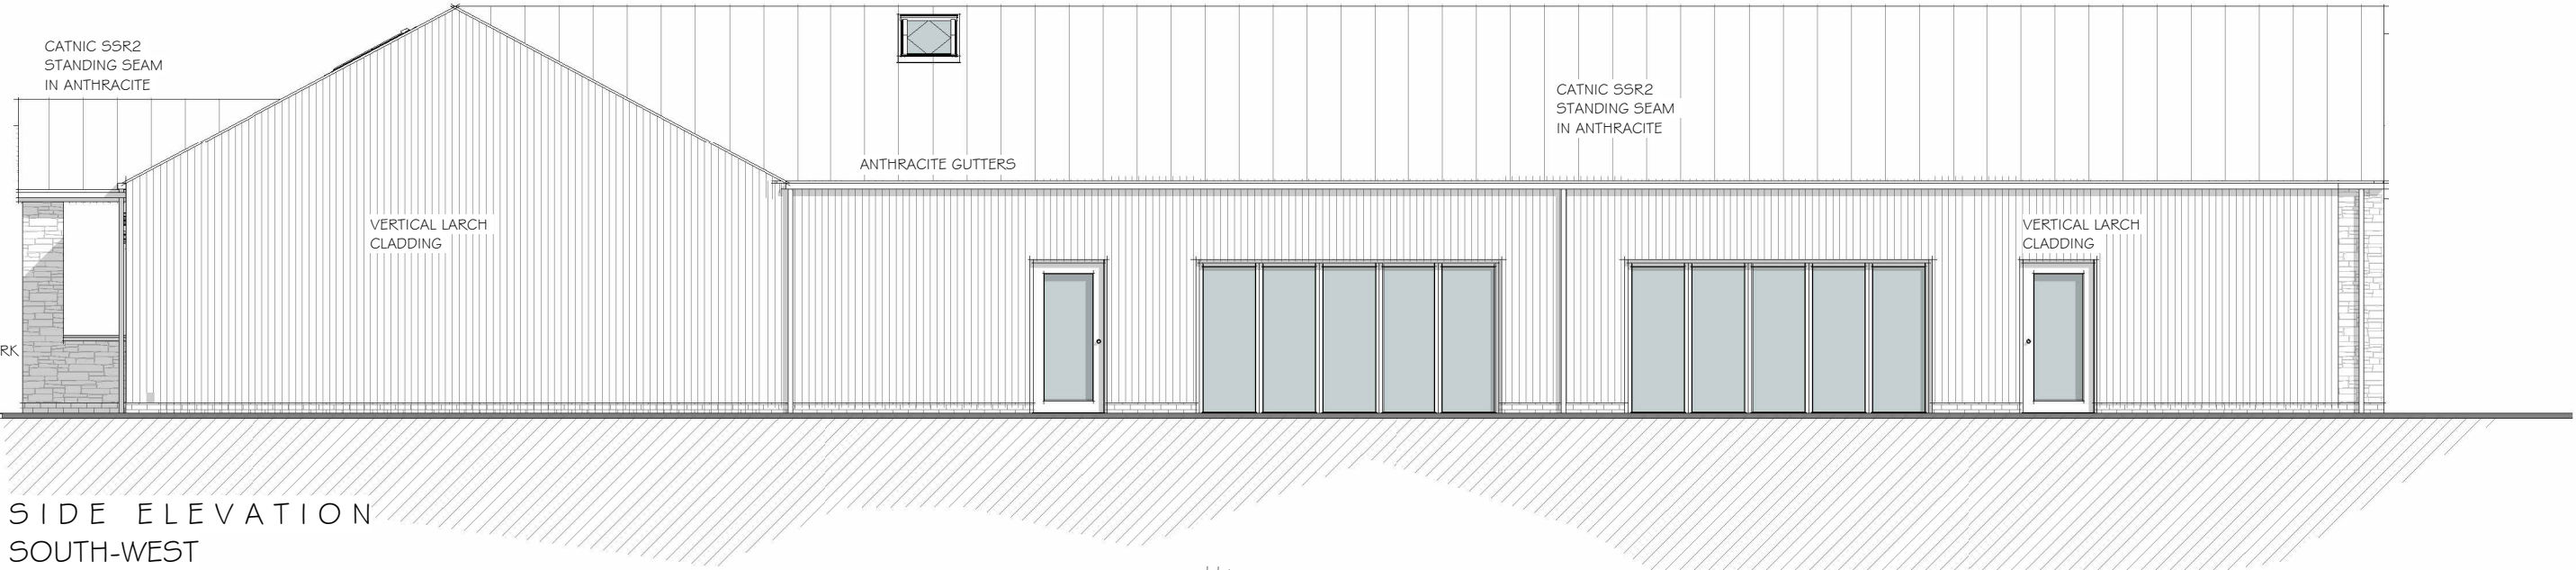

GROUND FLOOR PLAN

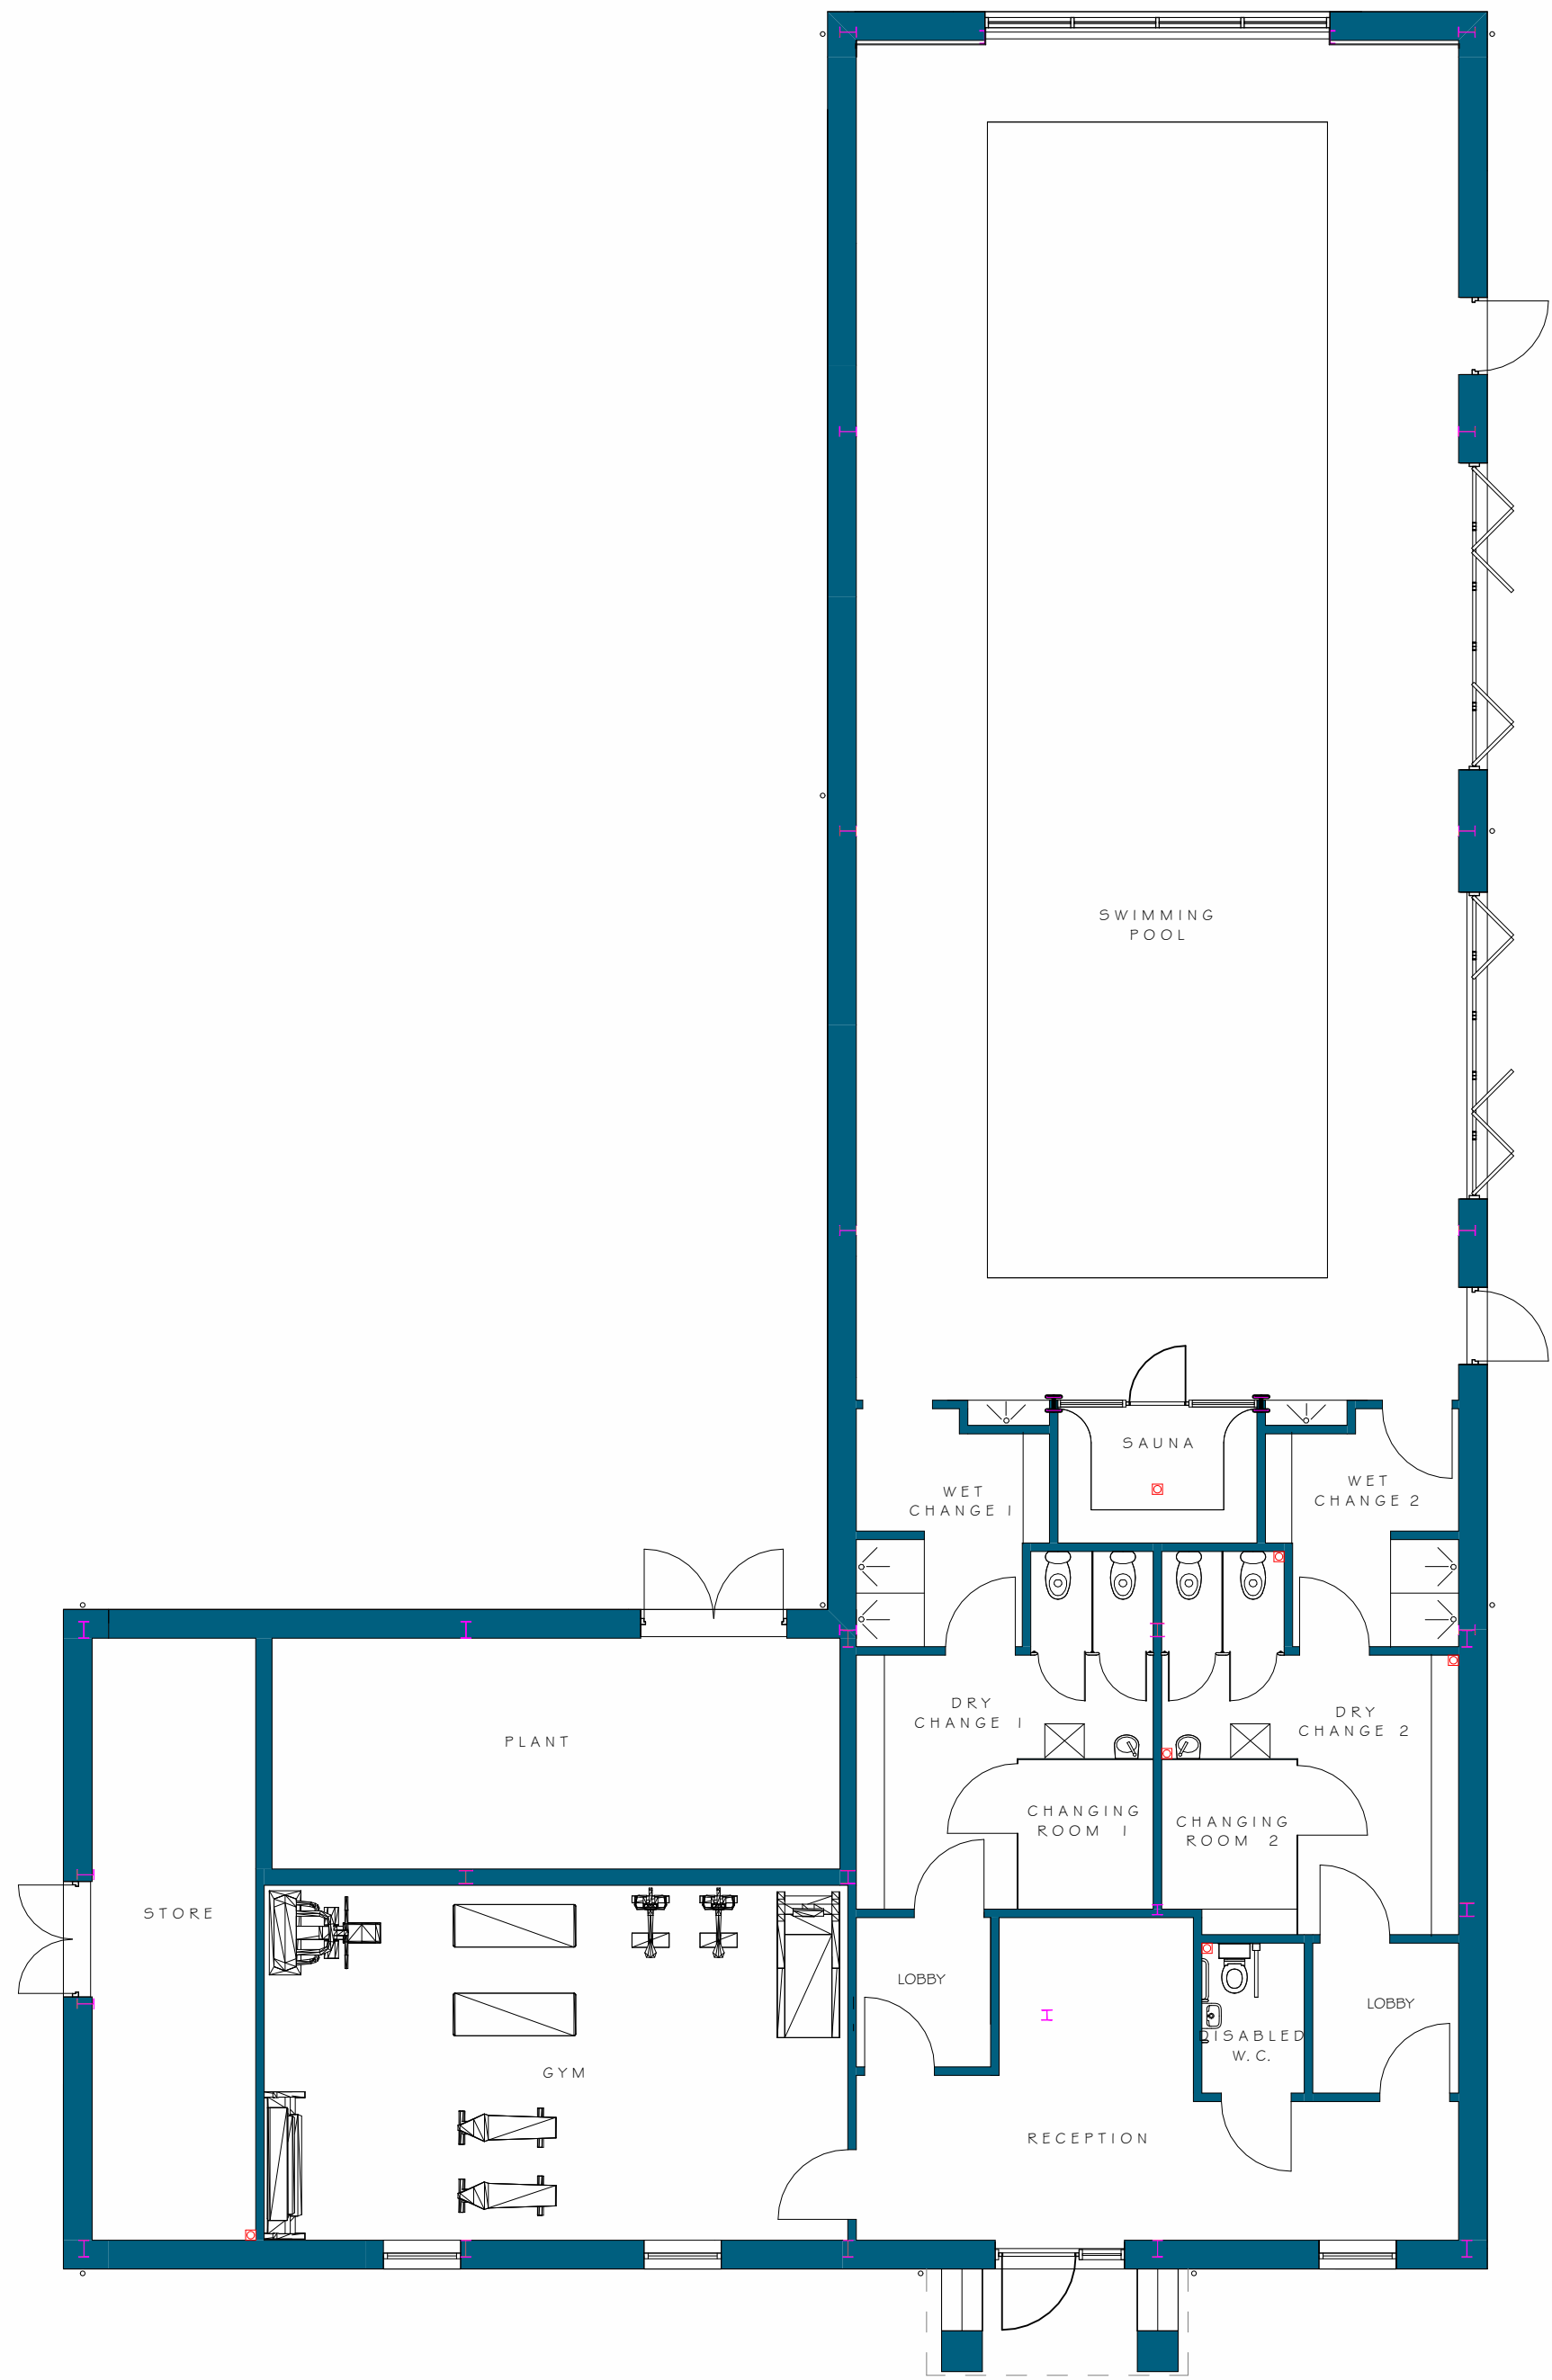

SIDE ELEVATION NORTH-EAST

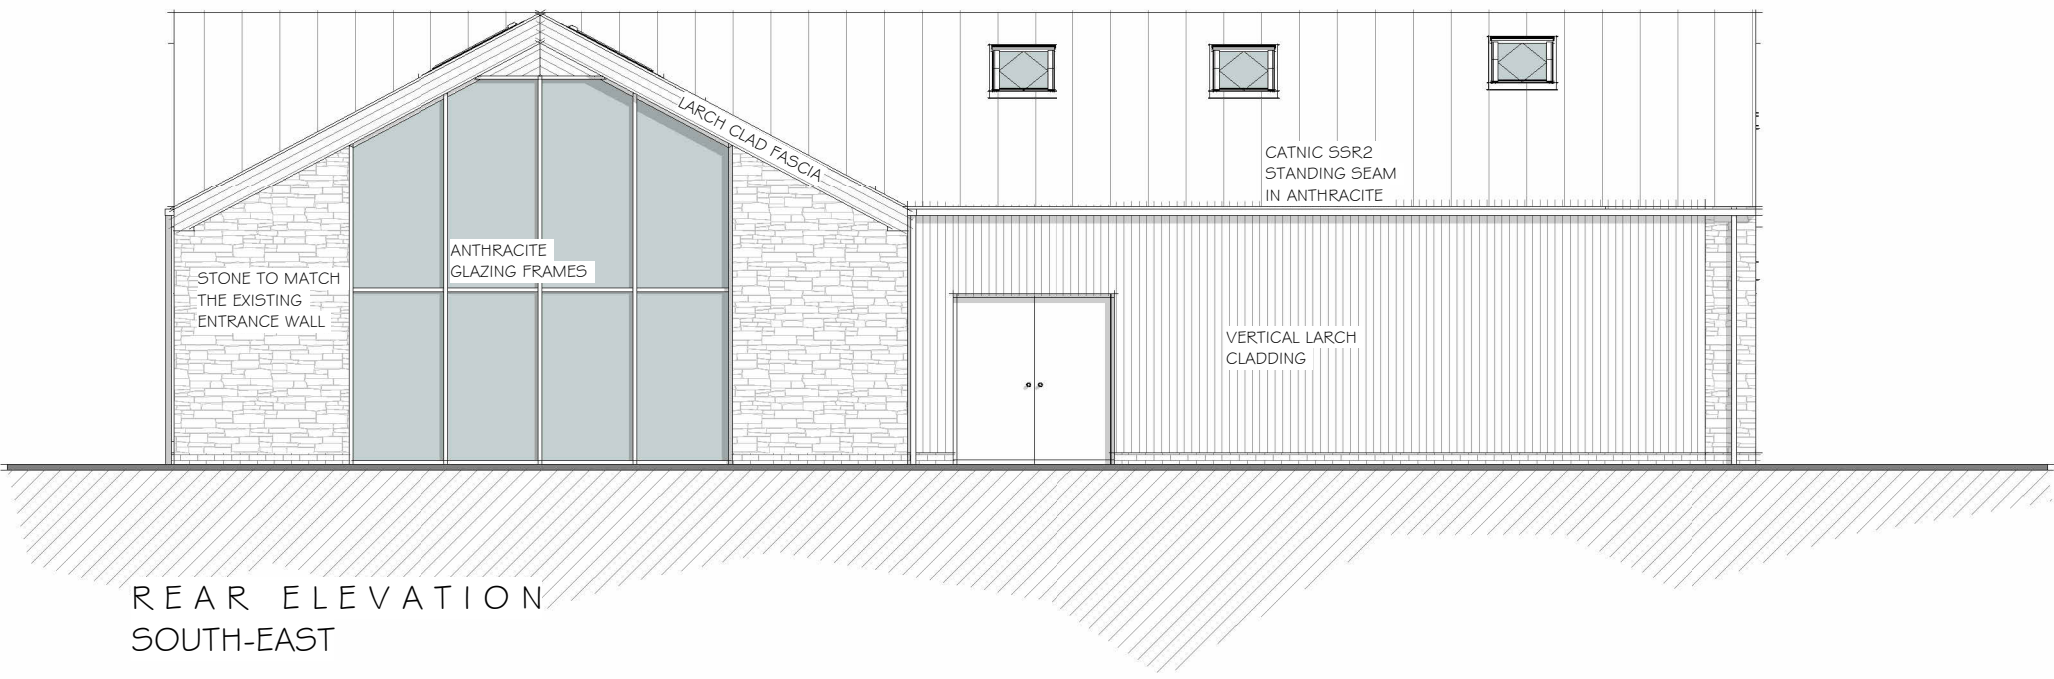

REAR ELEVATION SOUTH-EAST



REAR WINDOW - AS CONSTRUCTED



STONE WALLS TO MATCH THE EXISTING ENTRANCE WALL



VERTICAL LARCH CLADDING TO MATCH THE EXISTING LODGES



CATNIC SSR2 STANDING SEAM IN ANTHRACITE
<https://catnic.com/products/ssr2-roofing-and-cladding>



WINDOWS, DOORS, GUTTERS, DOWNPIPES & POSTS TO BE IN RAL 7016 (ANTHRACITE)

Rev C: Amended to show as built window positions & porch - JS 24/04/2023
Rev B: Rooflights added - AM 08/11/2022
Rev A: Planning amendments - AM 08/06/2022



Project: Proposed Leisure Complex at
Address: Knights Lodges, Bretby, Derbyshire
Client: Willshee
Drawing: Planning - Ground Floor Plan & Elevations
Job Ref: 1560W Date: 24/04/23
Drawn By: JS Checked By: DB
Scale: 1:100 Drawing No:
Paper size: A1 18C

MEMBER OF THE CHARTERED INSTITUTE OF BUILDING
MEMBER OF THE CHARTERED INSTITUTE OF ARCHITECTURAL TECHNOLOGISTS
AFFILIATE MEMBER OF THE ROYAL INSTITUTE OF BRITISH ARCHITECTS