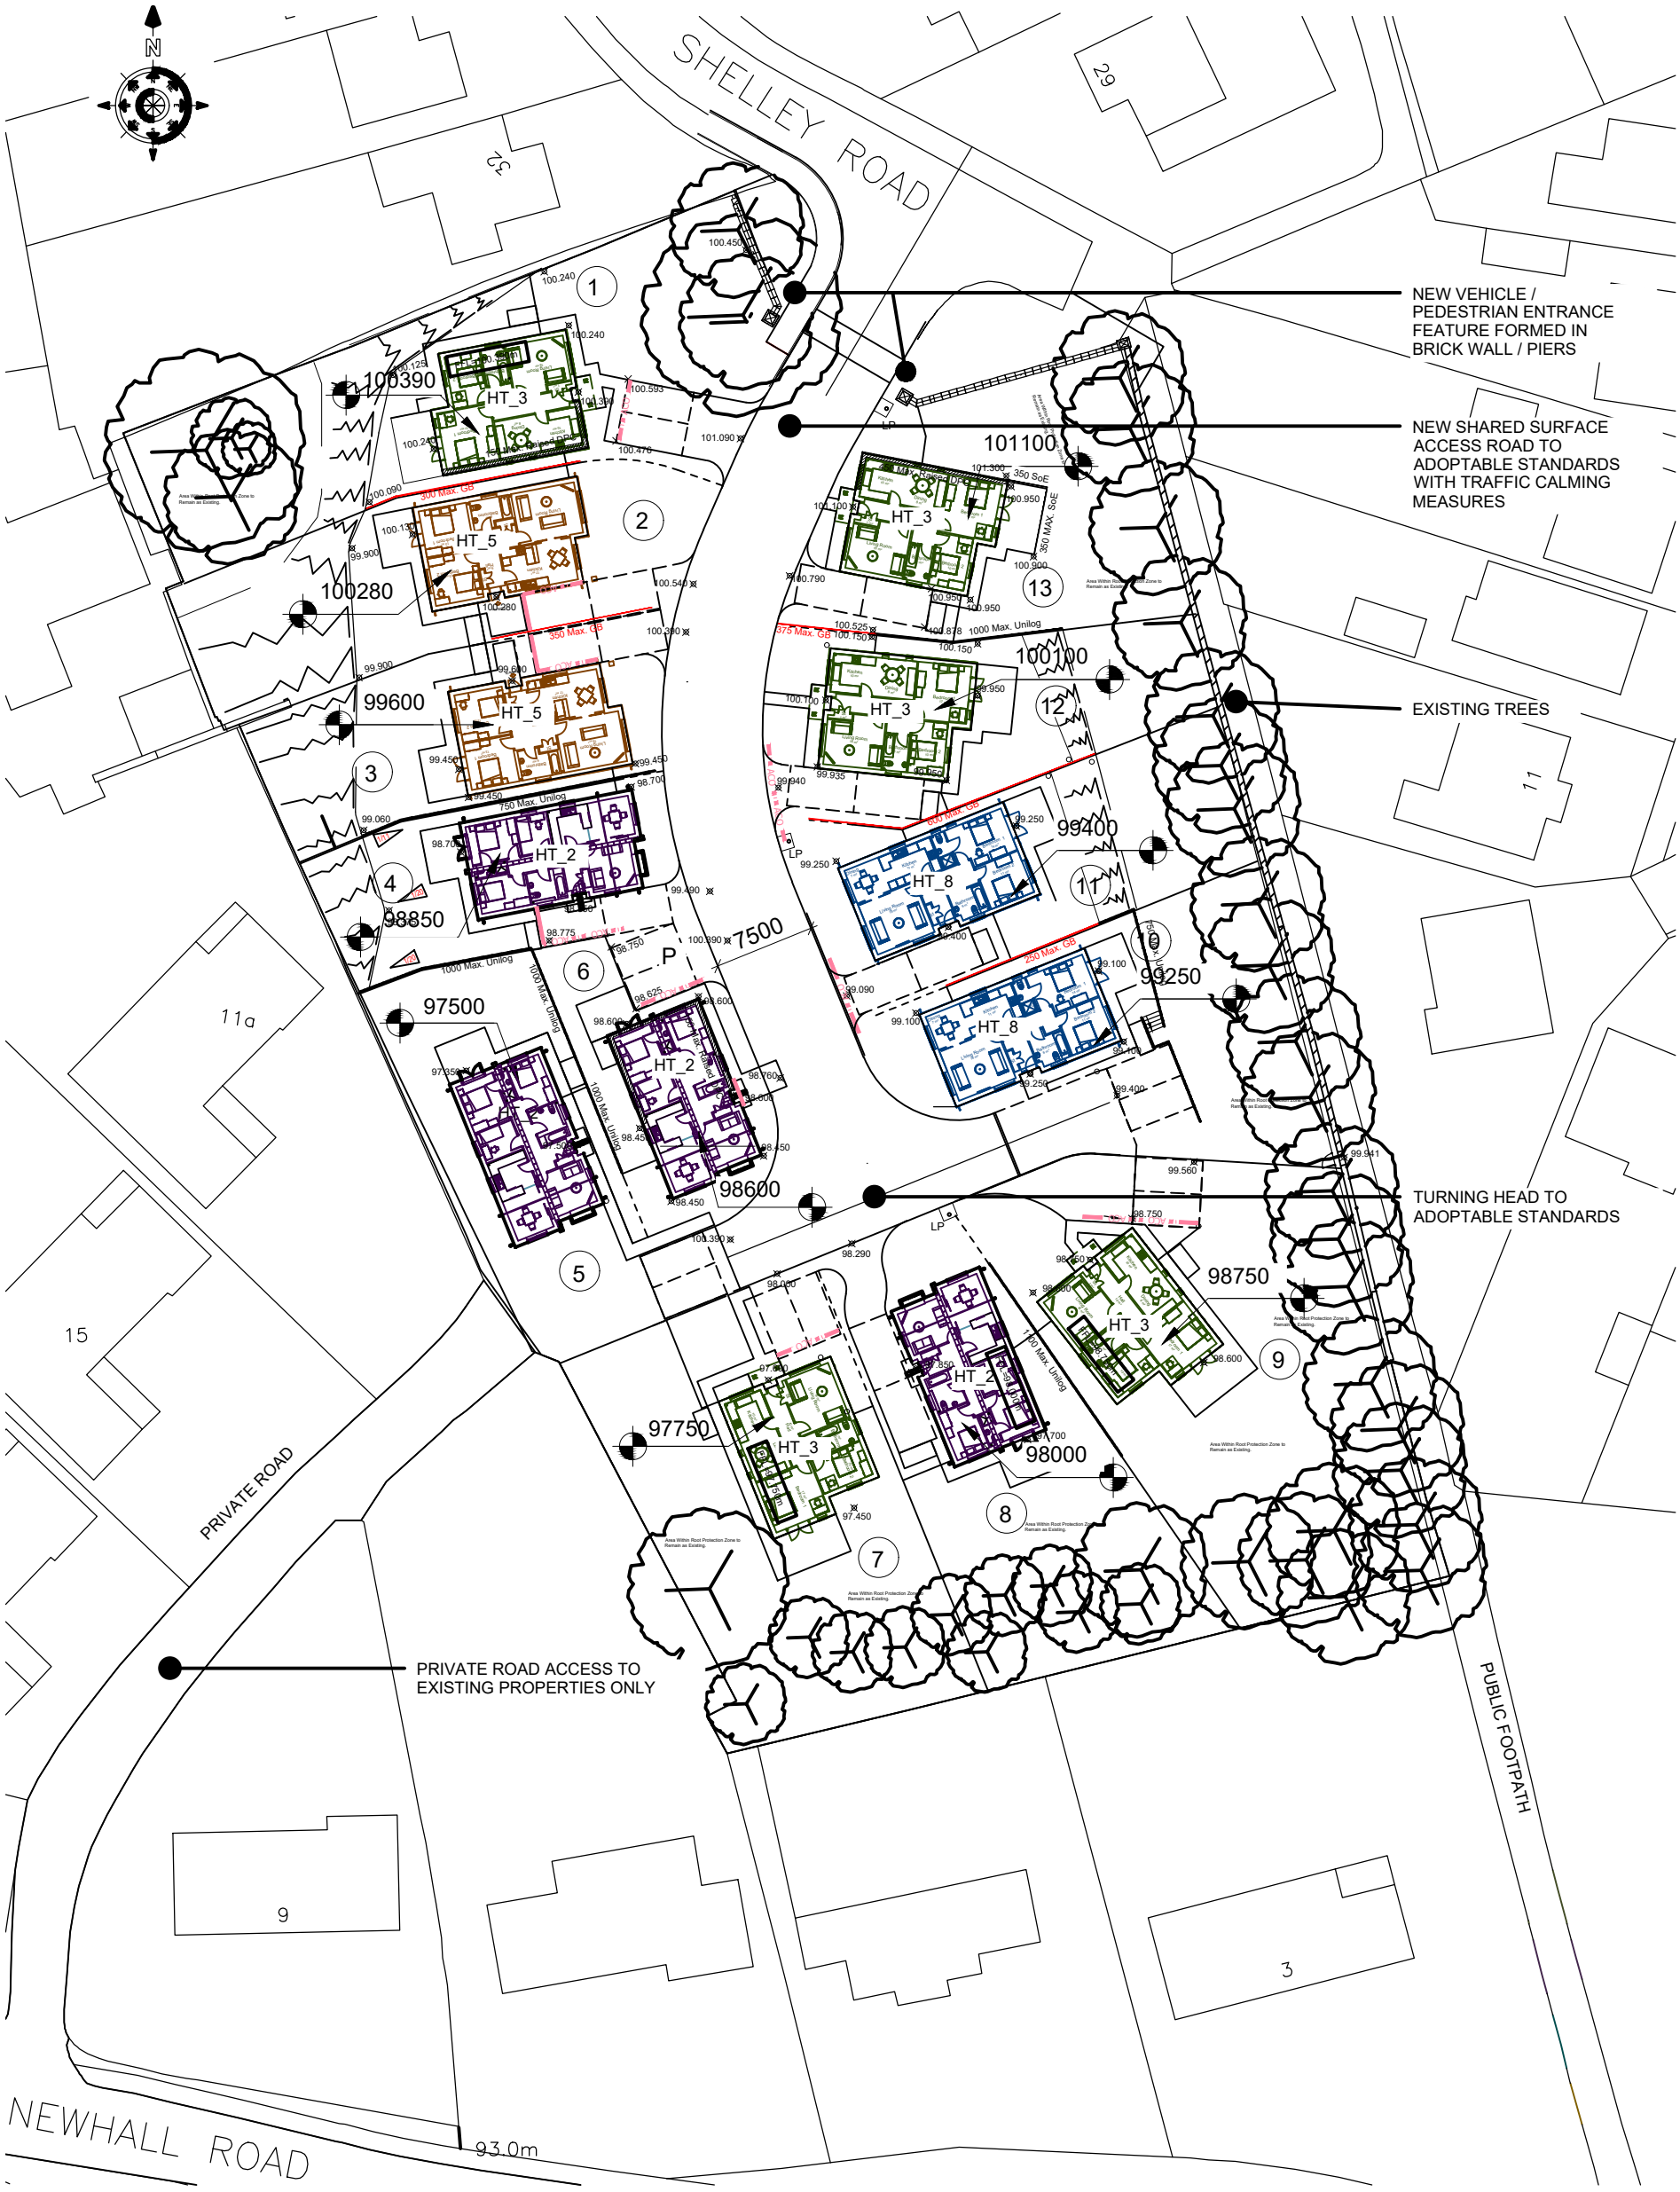


Site - Planning - Application with Floor Plans

1 : 500

©COPYRIGHT ALL RIGHTS RESERVED. THIS DRAWING MUST NOT BE REPRODUCED WITHOUT THE PERMISSION OF SPA ARCHITECTS

DO NOT SCALE, THE CONTRACTOR IS RESPONSIBLE FOR CHECKING DIMENSIONS UNLESS OTHERWISE STATED

REVISIONS :

C5 02.09.2019 As Built with adoptable FP omitted - djh
C4 21.08.2018 FFL amended up 150mm to Plots 7 & 8 - djh
C3 17.07.2018 Adoptable road redrawn to Topping Engineers design - djh
C2 07.06.2018 FFL amended to Plots 7 & 8 - djh
C1 22.05.2018 Tier road layout added. No1 repositioned. FFL updated - djh
P2 03.11.2017 Updated to reflect Highways and Planning Recommendations
P1 20.07.2017 Entrance Walls and Posts to Pedestrian access updated

Client : Mallard Homes (Swadlincote) Ltd

Project : Eureka Lodge Swadlincote

Drawing : Proposed Site Plan with House Floor Plans

Status : Construction | Date : 23/05/17

Drawn by : NRT | Checked by : MD | Scale : 1 : 500 @ A3

SPA ARCHITECTS
incorporating DKS Architects
1 Burdon Way, Stokesley Business Park, Stokesley, Middlesbrough. TS9 5PY
T: 01642 591555 E: mail@spa-architects.com

Project No :	Originator :	Volume / System :	Level / location :	Type :	Role :	Dwg No :
17051	SPA	ZZ	01	DR	A	[00]32

Suitability : CR | Suitability Description : | Rev : C05